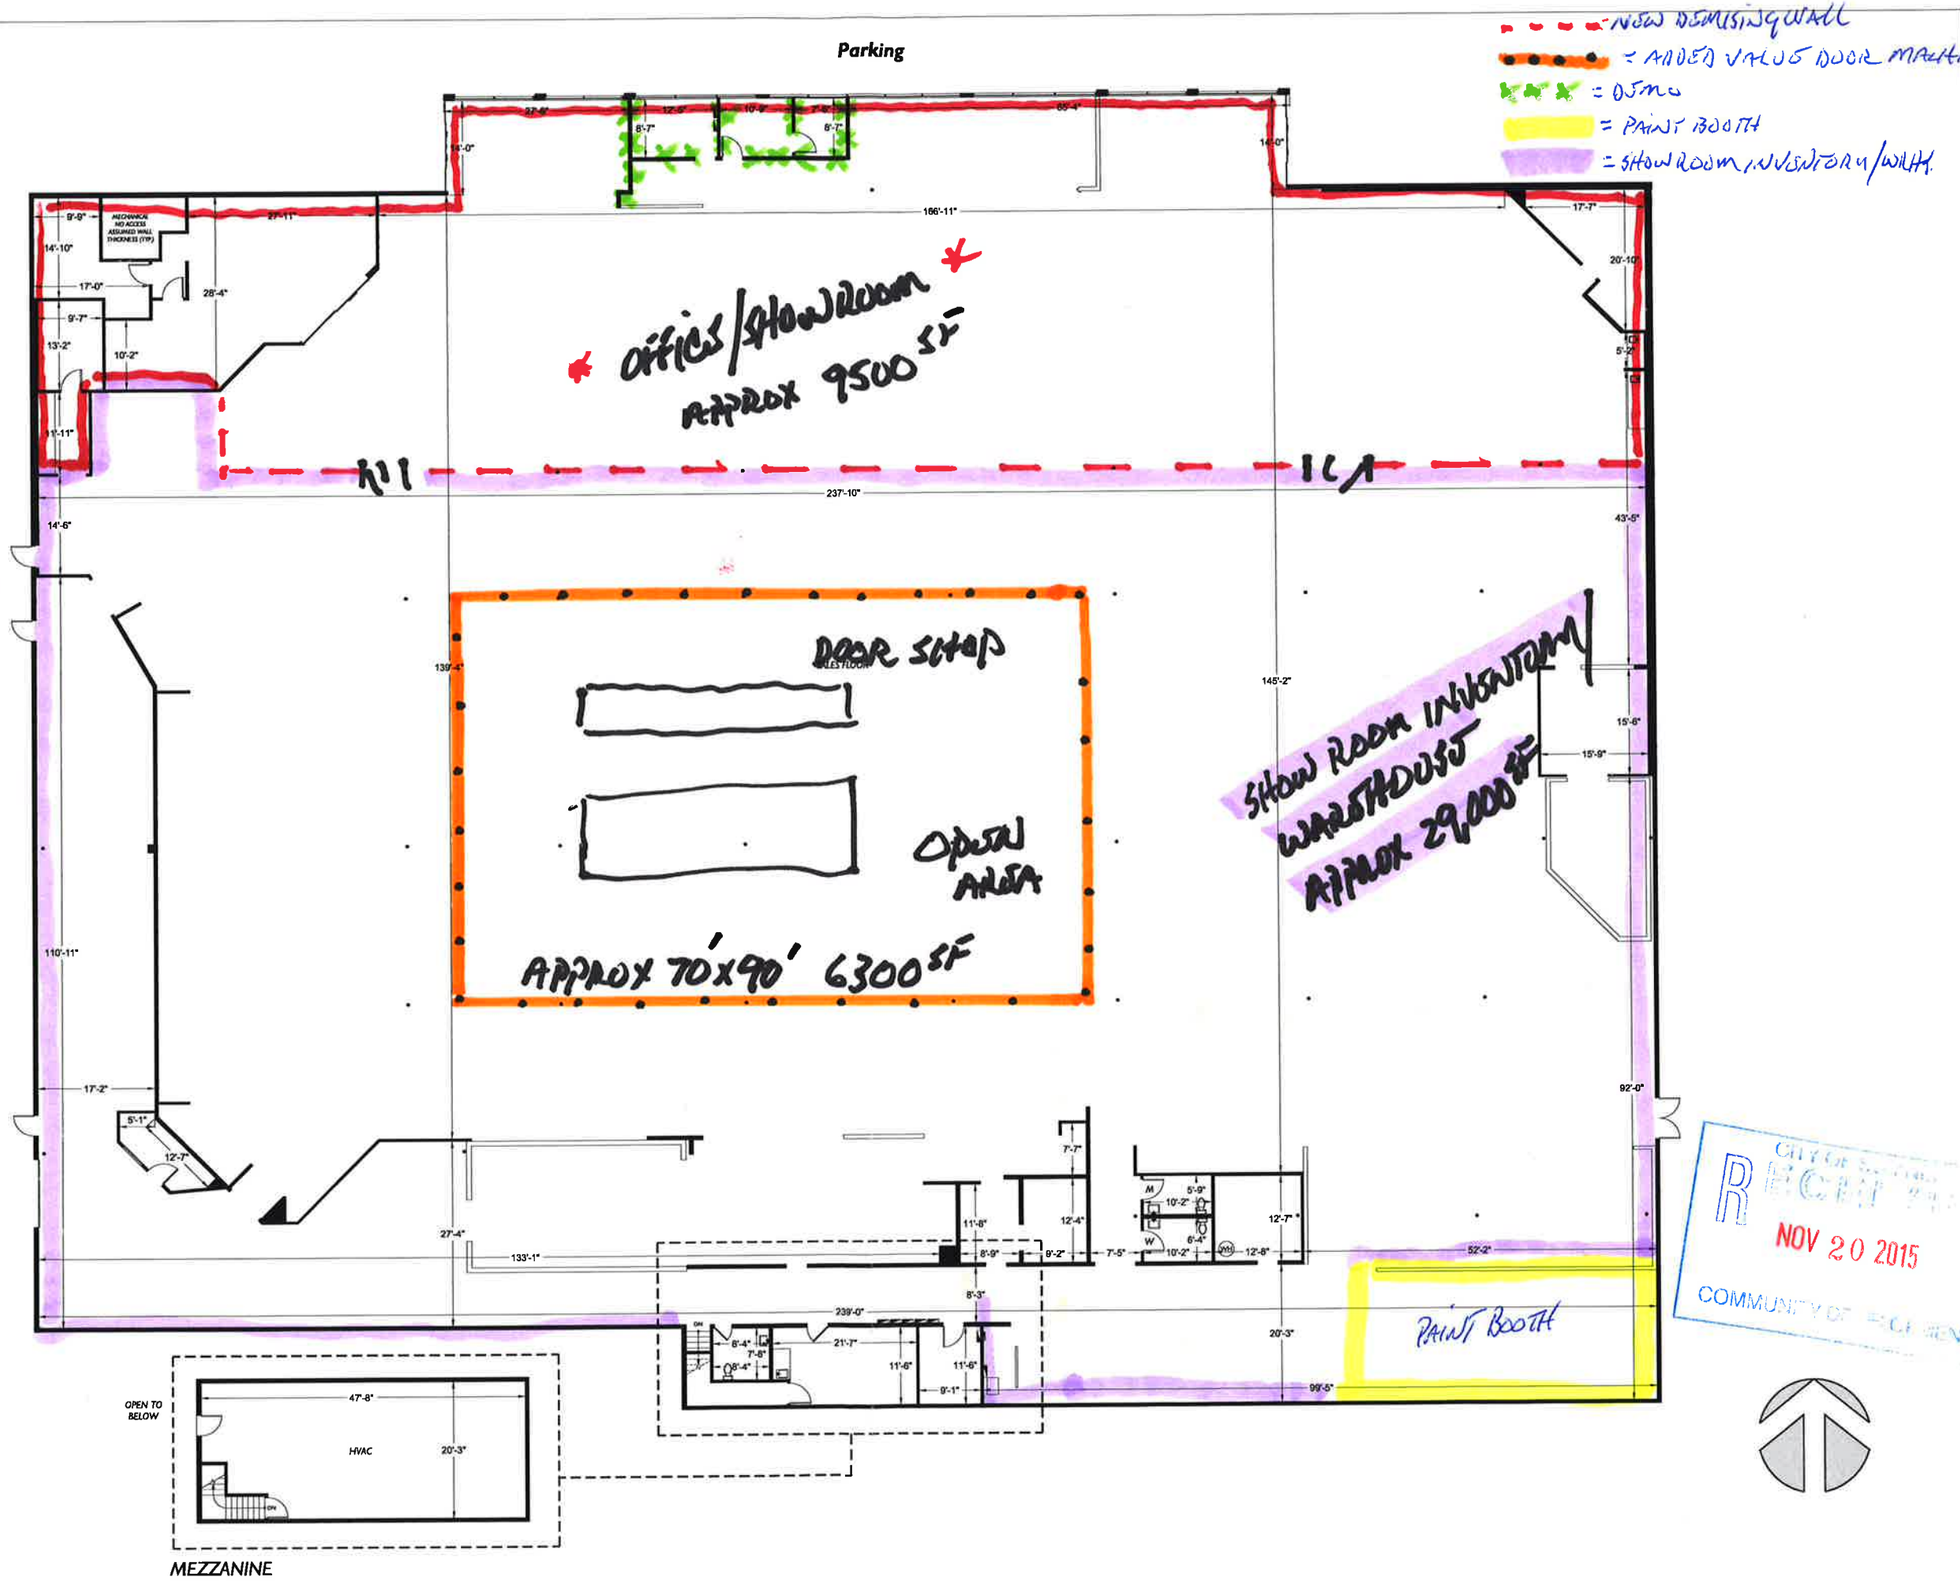

CITY OF SUMNER
RECEIVED
NOV 20 2015
COMMUNITY DEVELOPMENT

2D FLOOR PLANS
AS-BUILT FLOOR PLANS
2DFLOORPLANS.COM
206-328-7410 fax 206-328-4764
1700 21st Avenue South Suite 100
Seattle, WA 98144

Measured: March 2015

Project: C15-291

Scale

Floor Plan

Floor

Retail Building
6125 Parker Road East
Sumner, WA 98390

Subject

KIDDER MATHEWS
1201 Pacific Avenue Suite 1400
Tacoma, WA 98402

Client

REV 1 1/4 PLN 2015 00083